





DRAWING NOT TO SCALE

LEGEND

- ELECTRICITY POLE
- FIBRE OPTIC CABLE
- CABLE CONDUIT (TRENCHING)
- CABLE CONDUIT (BORE TUNNELLING)
- UE P2 PIT
- UE P5 PIT
- UE P6 PIT
- UE P8 PIT
- UE P9 PIT
- BL - BUILDING LINE
- BOK - BACK OF KERB
- CL - CENTRELINE OF CONDUIT
- TP - TURNING POINT OF CONDUIT
- FENCE LINE, FL
- TELSTRA MANHOLE
- TELSTRA PIT
- OPTICAL FIBRE JOINT
- JOINT LOOP (m) - POLE / UNDERGROUND
- CABLE HEAD POLE
- CABLE DEPTH

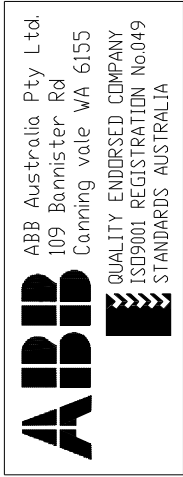

- Note:
- Conduit depths quoted are approximate only and may change due to unforeseen circumstances.
 - In all instances it is recommended that the position of conduits & cables should be proved on site by hand, prior to commencement of works.
 - Loop in all pits unless otherwise stated.

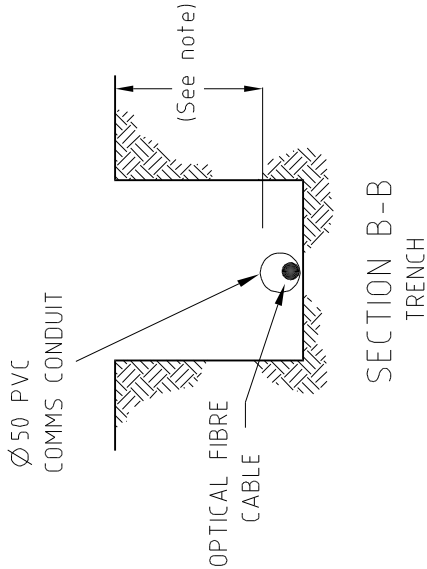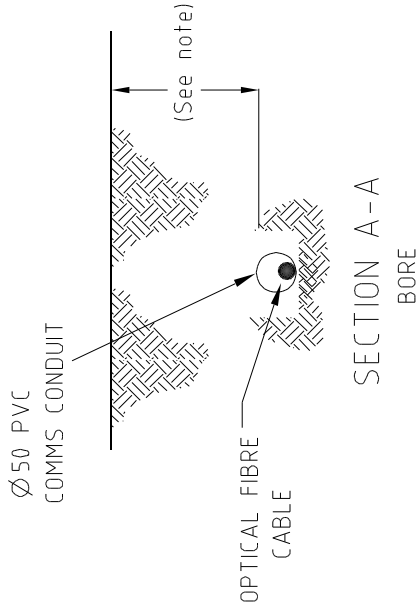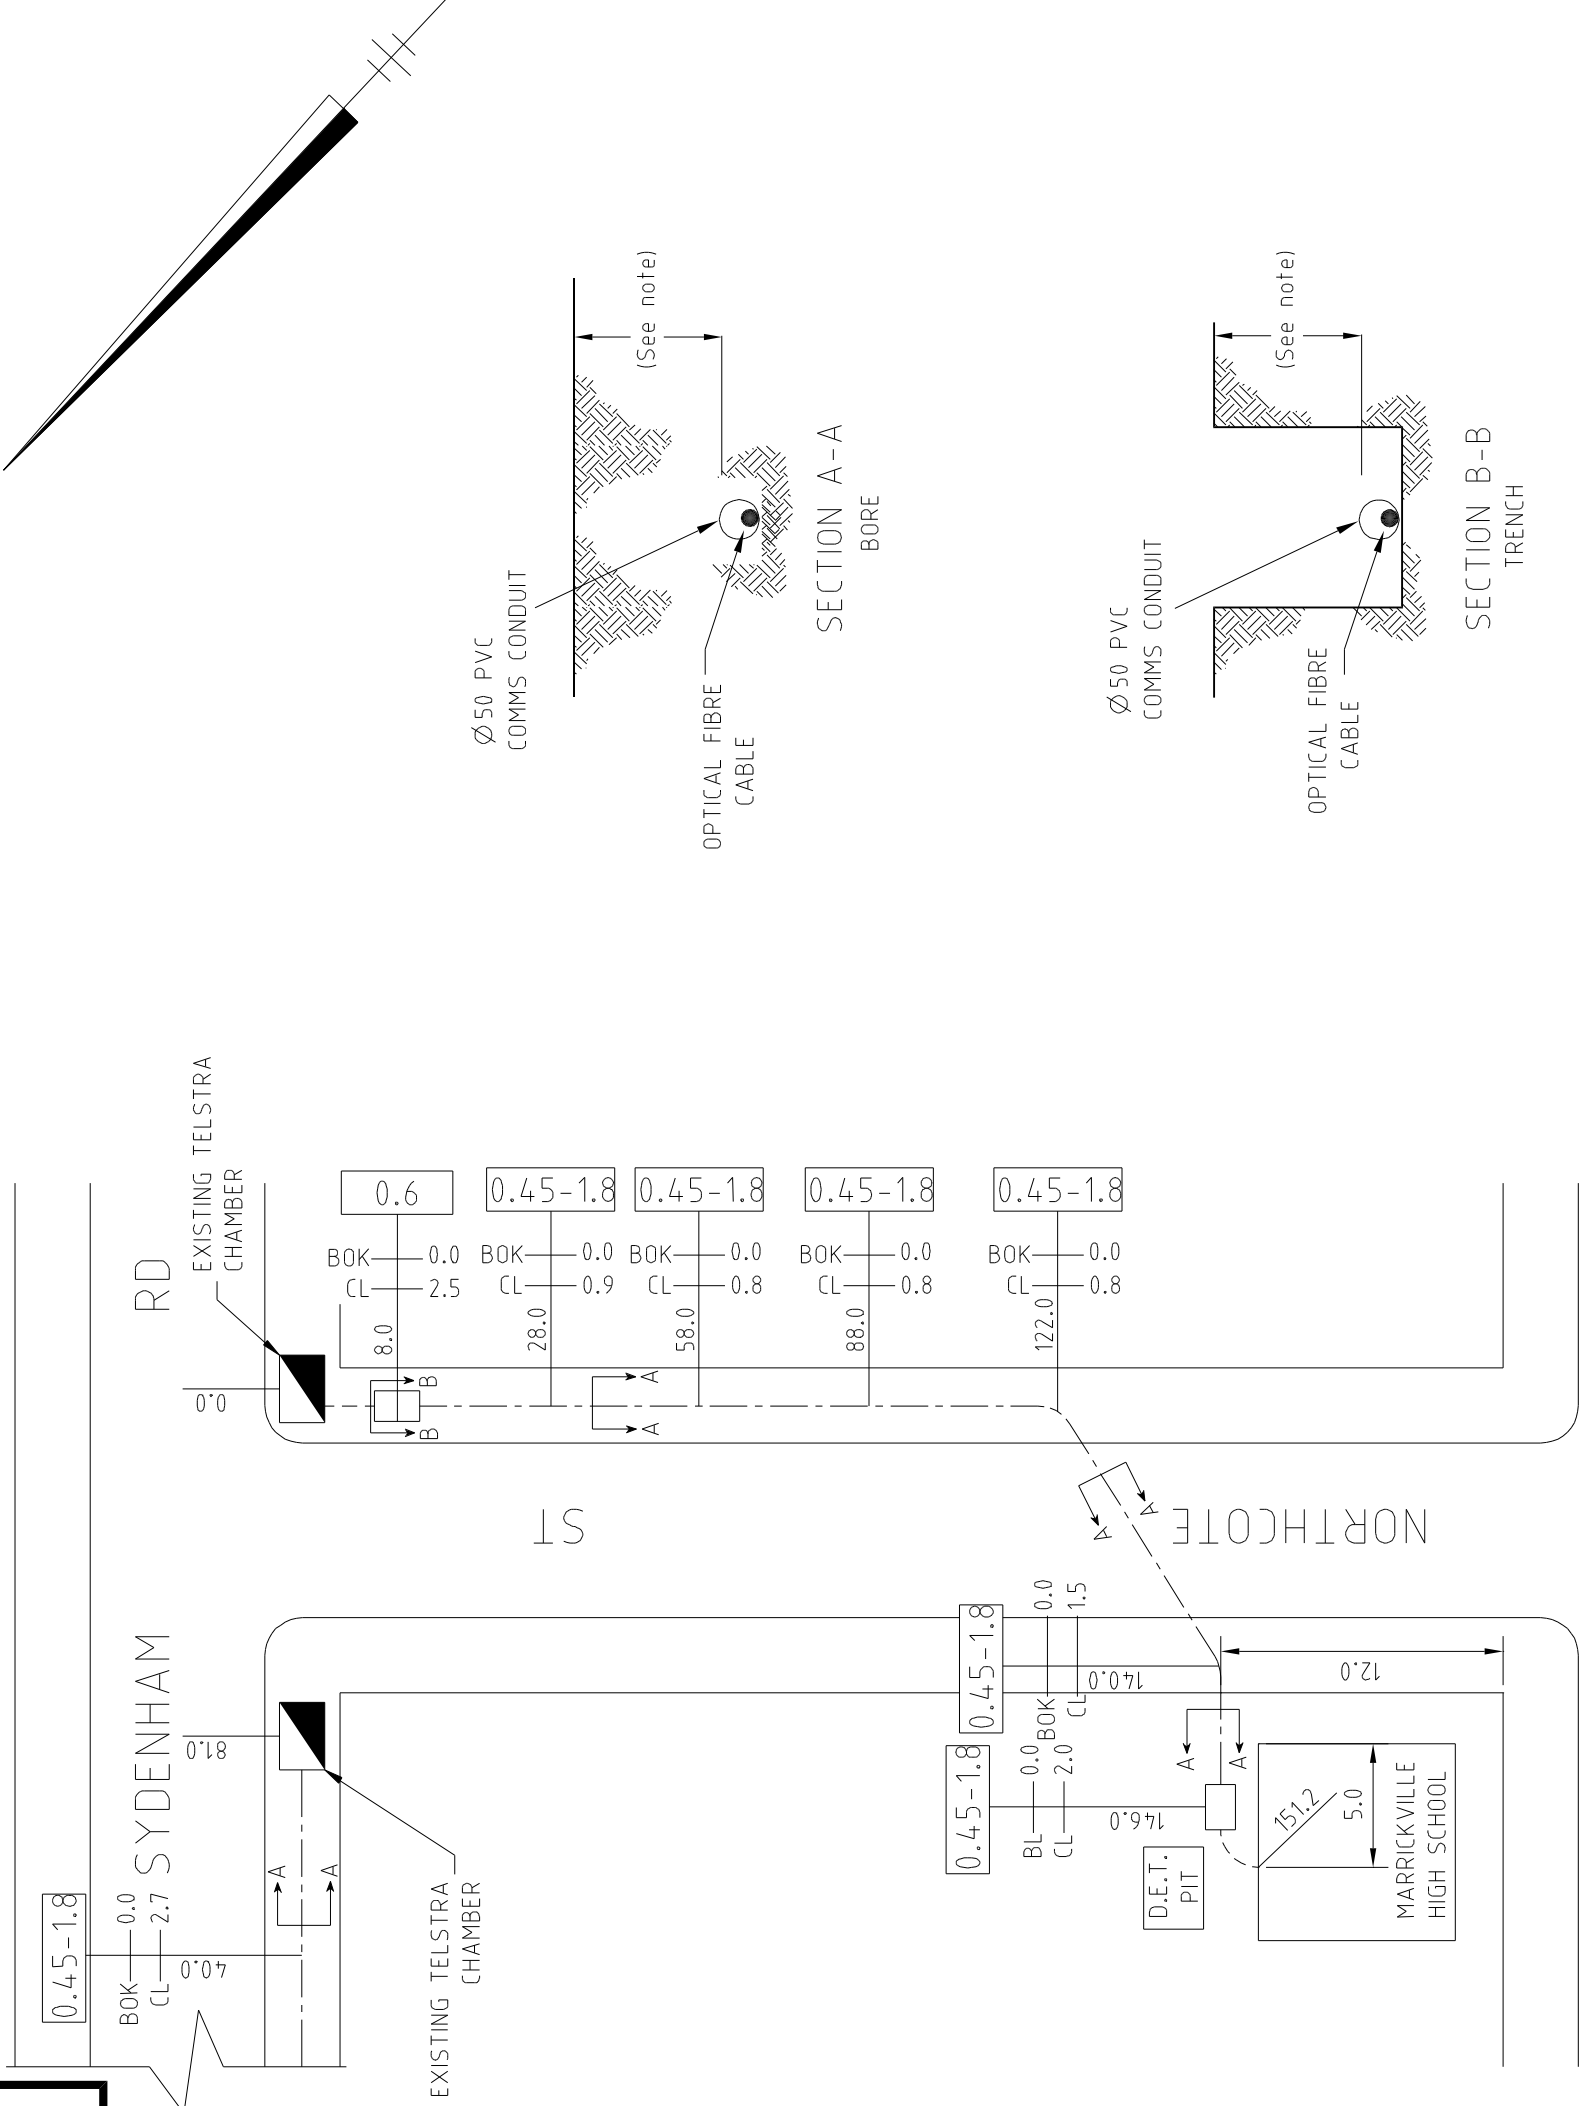

YABSLEY

RD

REVISION		DATE	REV.	REVISION DESCRIPTION	CHECKED	APP'D.
06.11.03	0			AS BUILT	MW	DC

CONTACT OFFICER	TREVOR SMITH PH: (02) 8226 3244
PROJECT NUMBER	UEC-DE&TS-427
PLAN No.	-
UBD REF	254-Q11

 Uecomm TM MAKING THE CONNECTION ACN 0719 003 116	DRAWN JMK 06.11.03
	DESIGN CHECKED MW 06.11.03
	APPROVED
UECOMM MEL / SYD / QLD	

DRG No. OFN5-SYD-2528-4	
EXTERNAL ROUTE (4 of 4) MARRICKVILLE HIGH SCHOOL (8540) NORTHCOTE STREET MARRICKVILLE 2204	
A3	