

DRAWING NOT TO SCALE



LEGEND

- - ELECTRICITY POLE
 ——— - FIBRE OPTIC CABLE
 - - - - - CABLE CONDUIT (TRENCHING)
 - - - - - CABLE CONDUIT (BORE TUNNELLING)

- | | |
|---|-------------|
|  | - UE P2 PIT |
|  | - UE P5 PIT |
|  | - UE P6 PIT |
|  | - UE P8 PIT |
|  | - UE P9 PIT |


- BL - BUILDING LINE
BOK - BACK OF KERB
CL - CENTRELINE OF CONDUIT
TP - TURNING POINT OF CONDUIT
— \ - FENCE LINE, FL

- TELSTRA MANHOLE
- TELSTRA PIT
- OPTICAL FIBRE JOINT
- JOINT LOOP (m) - POLE / UNDERGROUND
- CABLE HEAD POLE
- CABLE DEPTH

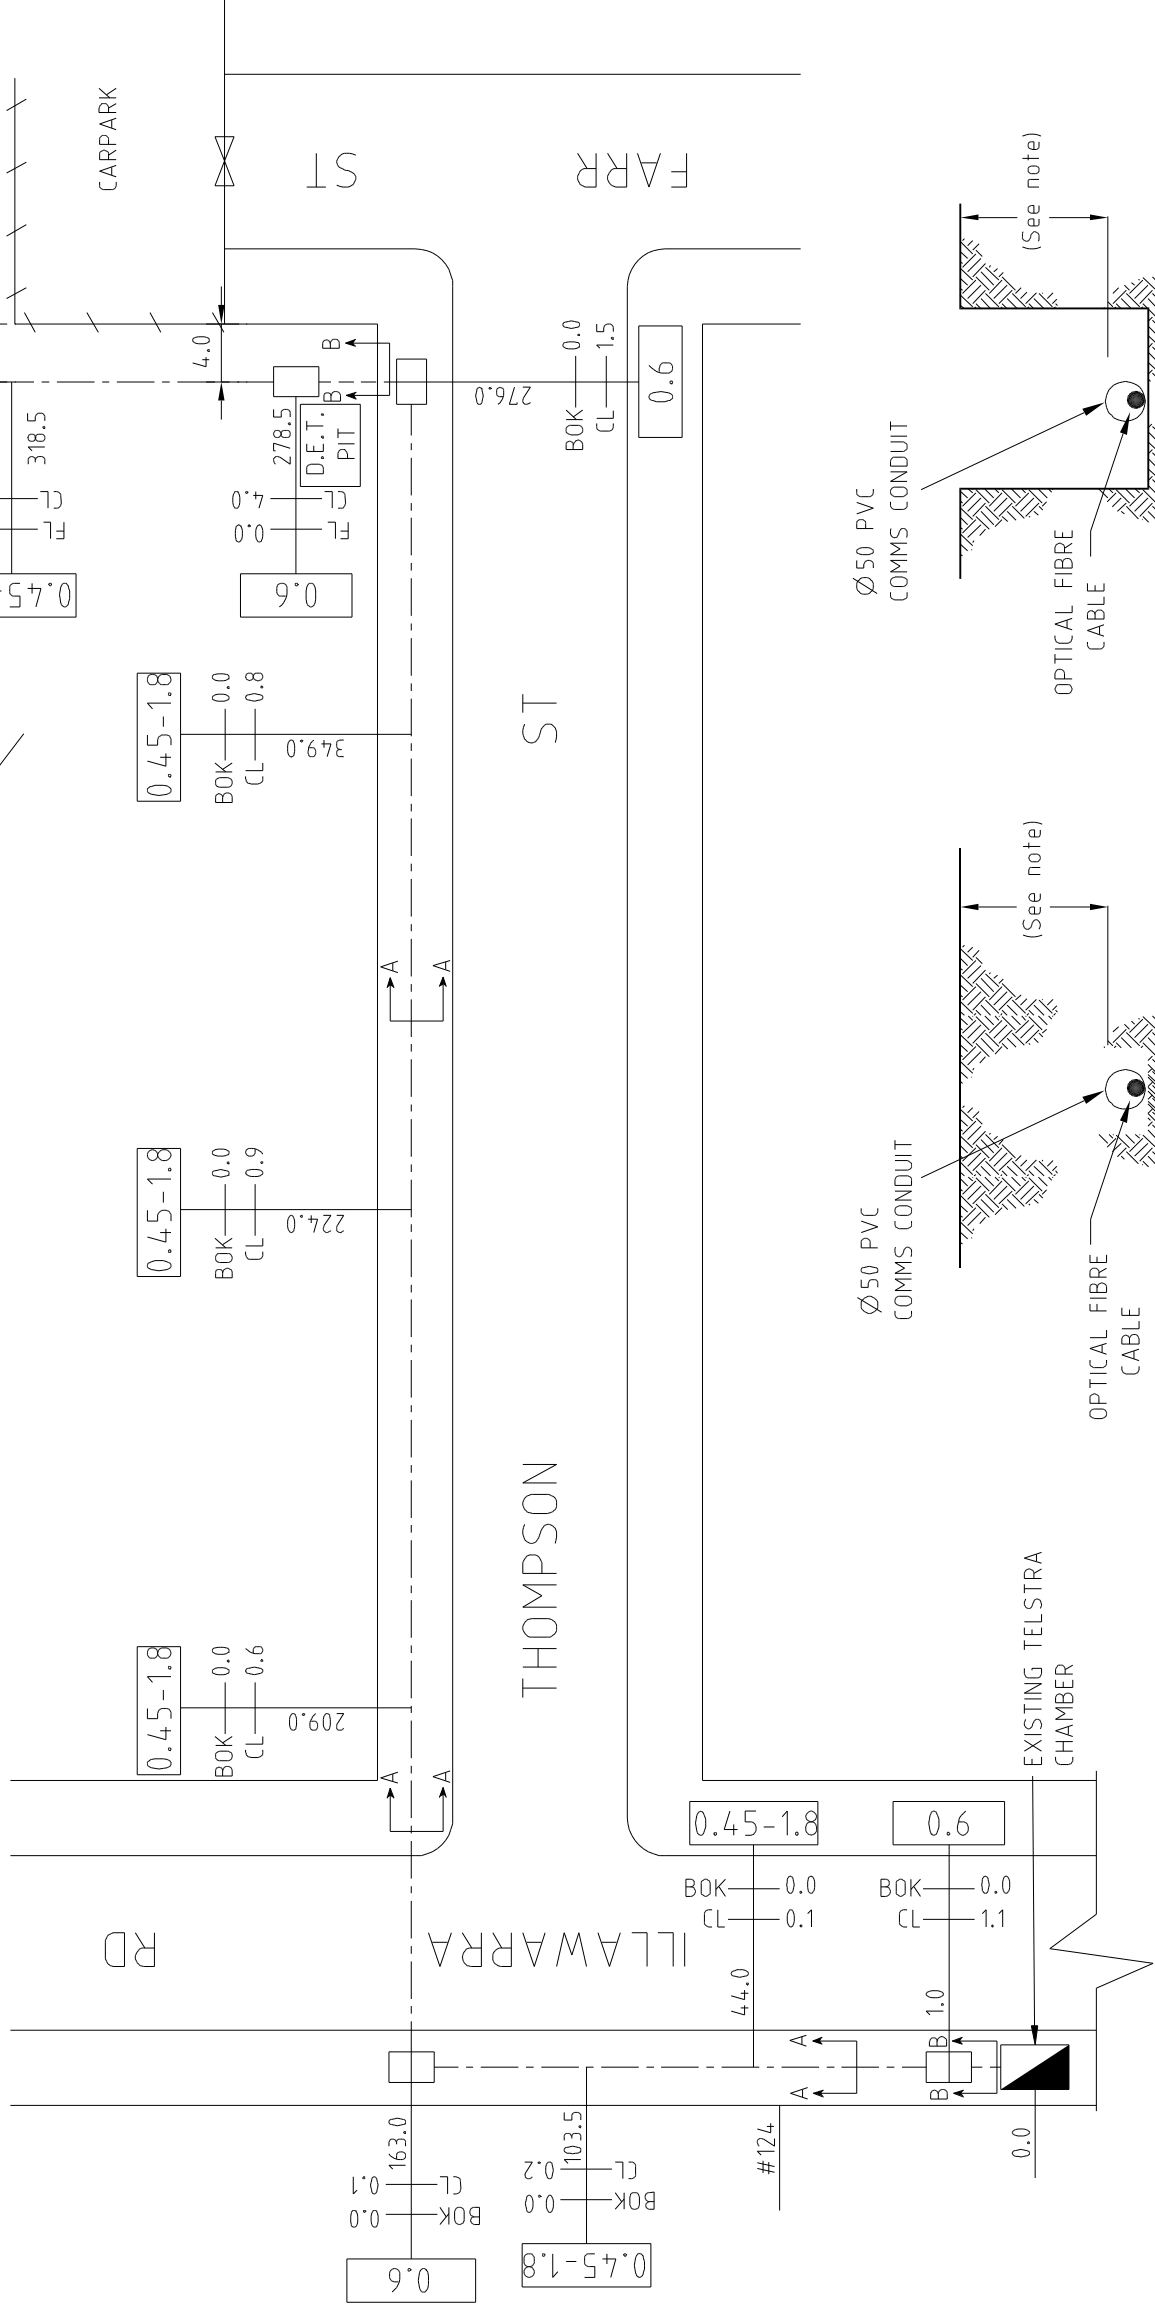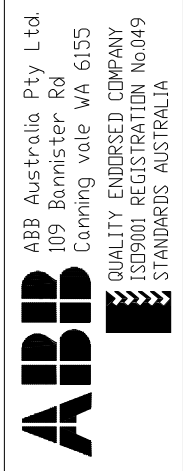

JOINS PLAN 1

- Note:
1. Conduit depths quoted are approximate only and may change due to unforeseen circumstances.
 2. In all instances it is recommended that the position of conduits & cables should be proved on site by hand, prior to commencement of works.
 3. Loop in all pits unless otherwise stated.

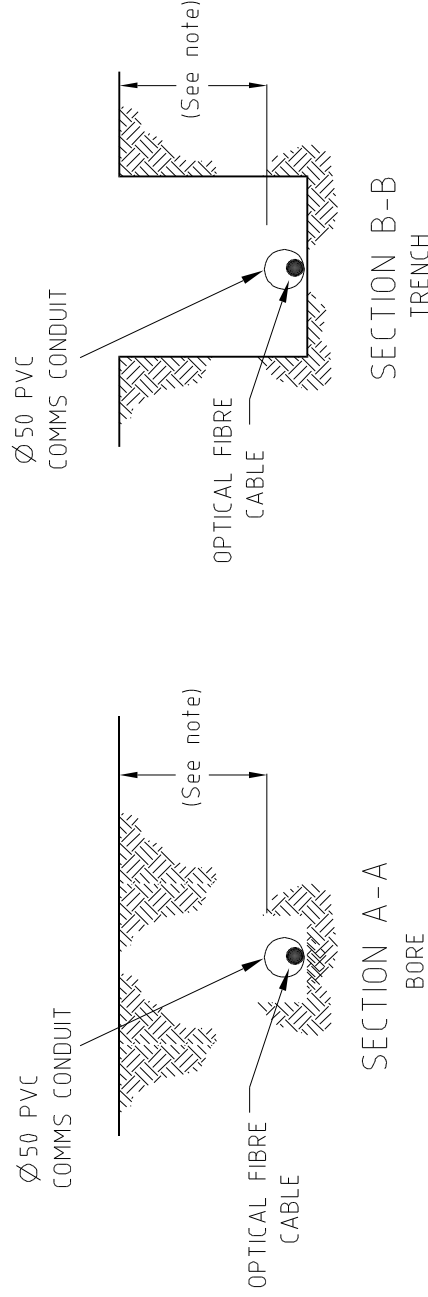

REVISION		08.11.03	0	AS BUILT	MW	DC
DATE	REV.	REVISION DESCRIPTION		CHECKED	APP'D.	

CONTACT OFFICER		TREVOR SMITH PH: (02) 8226 3244
PROJECT NUMBER		UEC-DE&TS-428
PLAN No.		-
UBD REF		255-B11

 Uecomm [™] MAKING THE CONNECTION ACN 079 003 195		DRAWN JMK 08.11.03 DESIGN CHECKED MW 08.11.03 APPROVED
UECOMM MEL / SYD / QLD		08.11.03 JC

DRG No.	0FN5-SYD-2529-2
EXTERNAL ROUTE (2 of 2) MARRICKVILLE PUBLIC SCHOOL (3952) CHAPEL STREET MARRICKVILLE 2204	

A3