

- - ELECTRICITY POLE

- - FIBRE OPTIC CABLE

- CABLE CONDUIT (TRENCHING)

- - - CABLE CONDUIT (BORE TUNNELLING)

- - UE P2 PIT

- ☐
- UE P5 PIT

- | | |
|--|-------------|
| | - UF P6 PIT |
|--|-------------|

- ☐

|--|-----------|

- BL - BUILDING LINE

- BOK - BACK OF KERB

- CI - CENTRELINE OF CONDUIT

- TP - TURNING POINT OF CONDUIT

- FENCE LINE —

- TEI STRA MANHOIE

-



















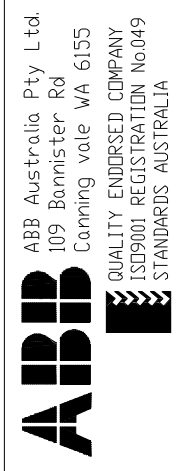


- (

- [illegible]

-

- 0.6m - CABLE DEPTH



Note:

1. Conduit depths quoted are approximate only and may change due to unforeseen circumstances.
2. In all instances it is recommended that the position of conduits & cables should be proved on site by hand, prior to commencement of works.
3. Loop in all pits unless otherwise stated.

REVISION				
DATE	REV.	AS BUILT	MW	DC
06.11.03	0			

CONTACT OFFICER	TREVOR SMITH PH: (02) 8226 3244
PROJECT NUMBER	UEC-DE&TS-427
PLAN No.	-
UBD REF	254-P9

 Uecomm [™] MAKING THE CONNECTION	DRAWN JMK 06.11.03	DESIGN CHECKED M.W. 06.11.03	APPROVED
	06.11.03 DC	06.11.03 DC	

DRG No. OFN5-SYD-2528-3	
EXTERNAL ROUTE (3 of 4)	
MARRICKVILLE HIGH SCHOOL (8540)	
NORTHCOTE STREET	
MARRICKVILLE 2204	
	A3

